

DART**NO LONGER APPLICABLE**

99.12.06 DS (SEE D206-540 REAR H)

DESIGN <i>KE</i>	DRAWN BY <i>KE</i>	DART AEROSPACE LTD HAWKESBURY, ONTARIO, CANADA	
CHECKED <i>CP</i>	APPROVED <i>CP</i>	DRAWING NO. DSI 9174	REV. A SHEET 1 OF 1
DATE 99.11.16		TITLE UTILITY BASKET INSTALLATION	SCALE NTS
A	99.11.16	NEW ISSUE	


DART SERVICE INSTRUCTION

AMEND PAGE 5 OF INSTALLATION DRAWING D206-540 REV G

CANADIAN STC: SH94-5
US FAA STC: SR00386NYREPLACE NUTS AND BOLTS WITH CASTLE
NUTS, PINS, AND BOLTS AS OUTLINED:

NEW HARDWARE

OLD HARDWARE

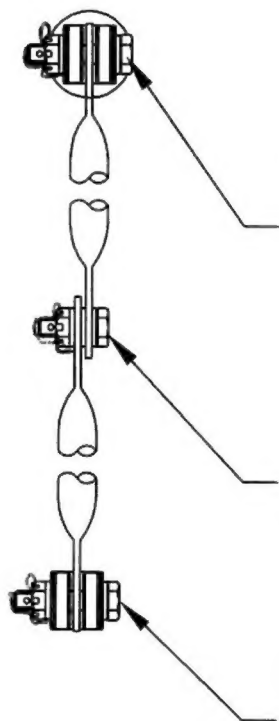

AN4-12 BOLT (1)
D2012-107 CLEVIS (1)
D2022-101 SPACER (2)
AN960JD416 WASHER (2)
AN320-4 NUT (1)
AN380-2-2 PIN (1)

AN4-6 BOLT (1)
AN960JD416 WASHER (3)
AN320-4 NUT (1)
AN380-2-2 PIN (1)

AN4-12 BOLT (1)
D2022-101 SPACER (2)
AN960JD416 WASHER (2)
AN320-4 NUT (1)
AN380-2-2 PIN (1)

~~AN4-10A BOLT (1)~~
~~D2012-107 CLEVIS (1)~~
~~D2022-101 SPACER (2)~~
~~AN960JD416 WASHER (1)~~
~~MS21042L4 NUT (1)~~

~~AN4-5A BOLT (1)~~
~~AN960JD416 WASHER (3)~~
~~MS21042L4 NUT (1)~~

~~AN4-10A BOLT (1)~~
~~D2022-101 SPACER (2)~~
~~AN960JD416 WASHER (1)~~
~~MS21042L4 NUT (1)~~